


Plan Scale 1:1000
 Profile Vert Scale 1:1000
 Profile Horz Scale 1:1000

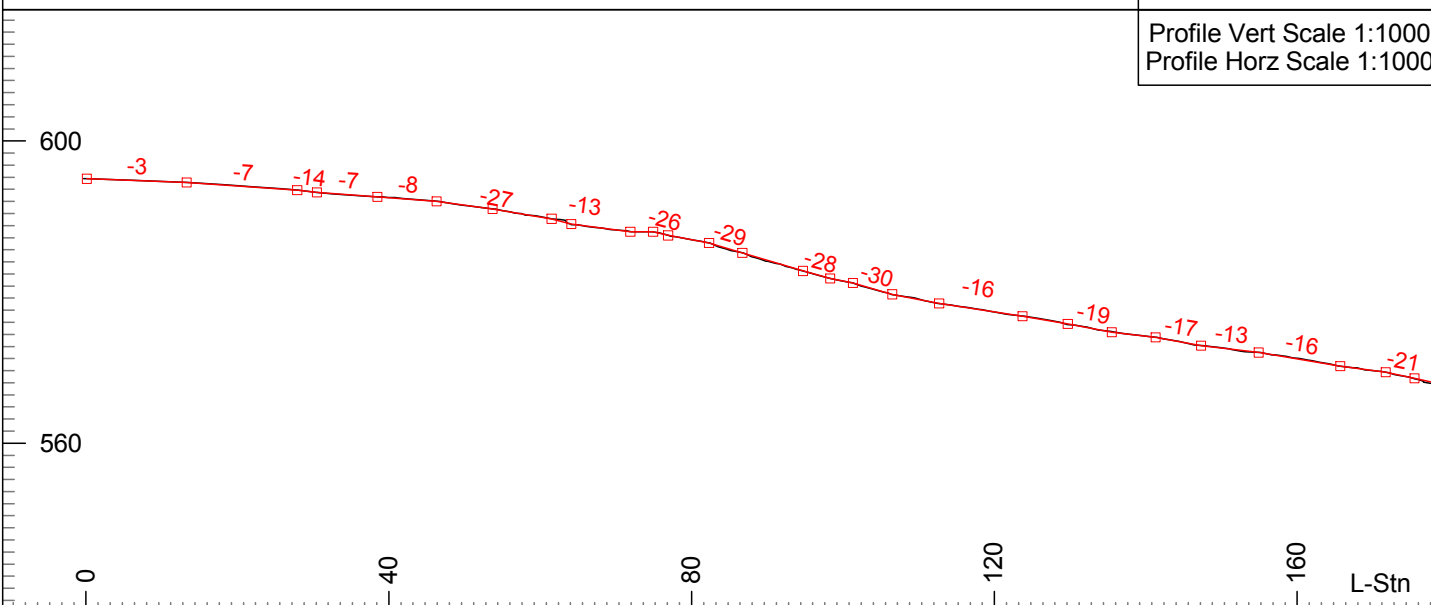


L-Stn m.	HD m.	SD m.	Grade %	H.Rad m.
* 0.1	13.3	13.3	-3.4	
* 13.3	14.6	14.6	-7.0	
* 27.9	2.6	2.6	-13.8	
* 30.5	6.6	6.6	-7.0	
* 37.1	1.4	1.4	-7.0	25.0
* 38.5	2.1	2.1	-7.7	25.0
* 40.6	5.7	5.8	-7.7	
* 46.3	6.5	6.5	-13.2	
* 52.8	0.9	0.9	-13.2	15.0
* 53.7	7.8	7.9	-16.7	15.0
* 61.5	2.6	2.7	-26.9	15.0
* 64.1	7.8	7.9	-12.8	15.0
71.9	3.0	3.0	-0.7	15.0
74.9	2.0	2.1	-26.0	15.0
76.9	5.4	5.5	-18.1	15.0
82.3	4.4	4.6	-29.1	15.0
86.7	7.1	7.4	-30.2	15.0
93.9	0.9	0.9	-30.2	
94.7	3.6	3.7	-27.8	
98.3	1.4	1.4	-19.3	
99.7	1.6	1.6	-19.3	120.0
101.3	5.2	5.4	-30.0	120.0
106.5	6.2	6.3	-18.1	120.0
112.7	11.0	11.1	-16.0	120.0
123.7	6.0	6.1	-16.0	120.0
129.7	2.2	2.2	-19.0	120.0
132.0	3.6	3.7	-19.0	
135.5	1.5	1.5	-13.1	
137.0	4.3	4.4	-13.1	-40.0
141.3	6.0	6.1	-17.0	-40.0
147.3	7.6	7.7	-12.6	-40.0
154.9	10.8	10.9	-16.3	-40.0
165.7	6.0	6.1	-14.0	-40.0
171.7				

Created By: Alex Forrester, P.Eng, R.P.F
 Date: January 18, 2016

As-built Drawing:
 KM-1454 Reverse Curve Swithbacks
 Drawing Issued For: Reference


Page 1 of 3



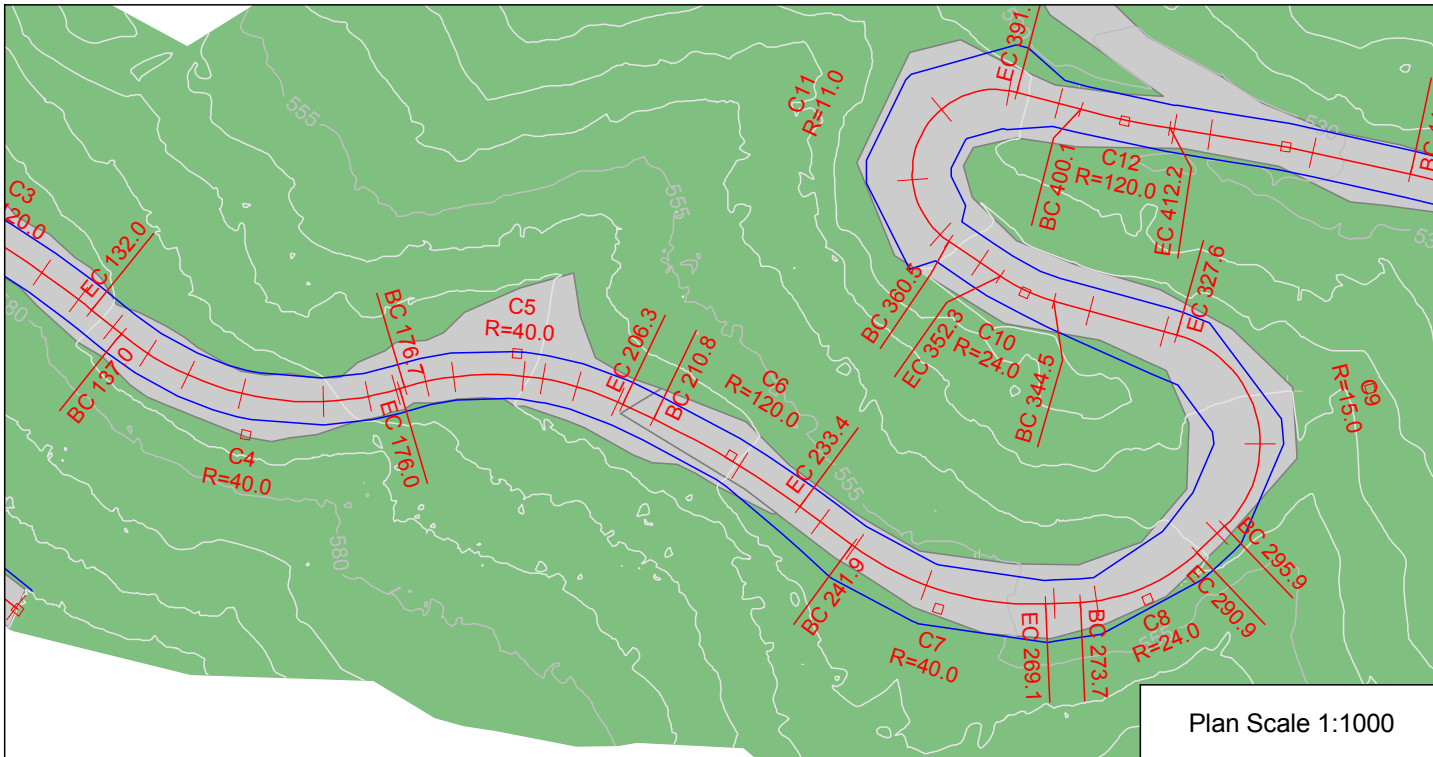

Plan Scale 1:1000
 Profile Vert Scale 1:1000
 Profile Horz Scale 1:1000

L-Stn m.	HD m.	SD m.	Grade %	H.Rad m.
154.9	10.8	10.9	-16.3	-40.0
165.7	6.0	6.1	-14.0	-40.0
171.7	3.8	3.9	-20.5	-40.0
175.5	0.4	0.4	-23.0	-40.0
176.0	0.7	0.8	-23.0	
176.7	2.8	2.9	-23.0	40.0
179.5	3.8	3.9	-25.8	40.0
183.3	9.2	9.3	-15.9	40.0
192.5	2.6	2.7	-31.5	40.0
195.1	4.6	4.6	-10.4	40.0
199.7	5.8	5.9	-16.2	40.0
205.5	0.7	0.7	-17.0	40.0
206.3	4.5	4.6	-17.0	
210.8	13.0	13.2	-17.0	120.0
223.7	9.6	9.8	-16.0	120.0
233.4	3.4	3.4	-16.0	
236.7	5.2	5.2	-12.5	
241.9	0.4	0.4	-12.5	-40.0
242.3	10.8	10.8	-7.6	-40.0
253.1	16.0	16.1	-12.0	-40.0
269.1	1.2	1.2	-12.0	
270.3	3.4	3.4	-14.6	
273.7	2.2	2.2	-14.6	-24.0
275.9	14.9	15.3	-21.8	-24.0
290.9	3.7	3.8	-21.8	
294.5	1.4	1.4	-23.8	
295.9	12.2	12.6	-23.8	-15.0
308.1	19.5	19.8	-17.4	-15.0
327.6				

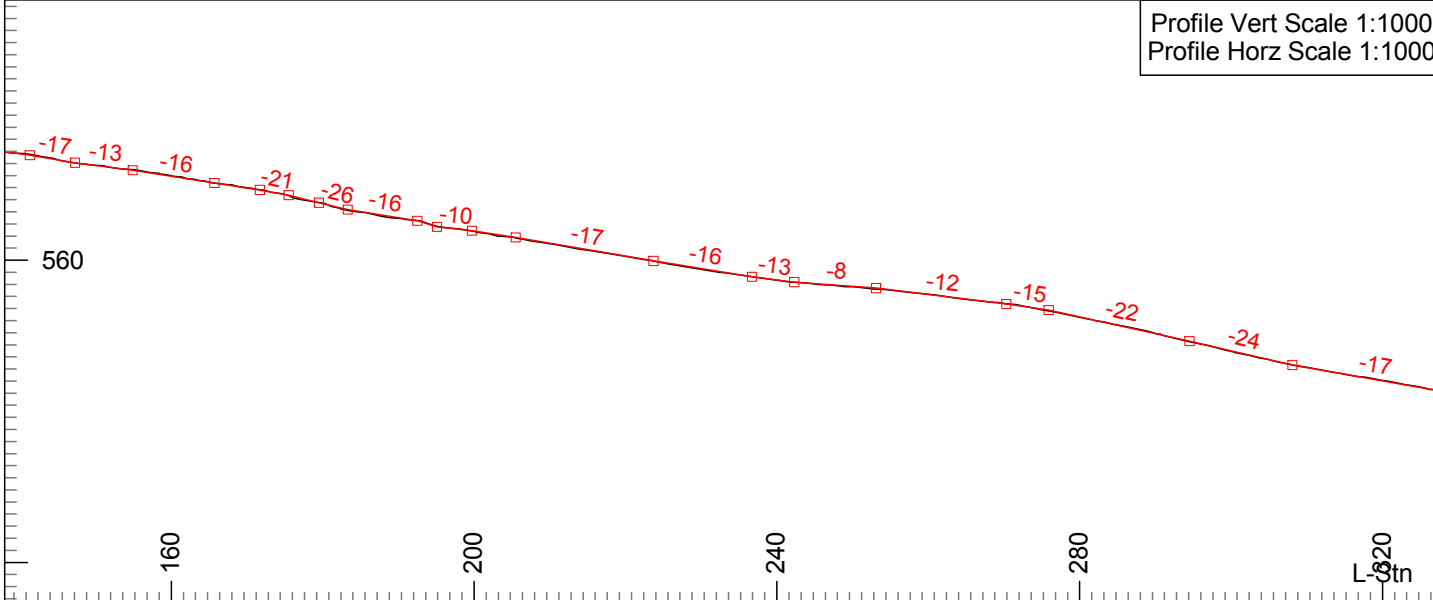


Created By: Alex Forrester, P.Eng, R.P.F
 Date: January 18, 2016


As-built Drawing:
 KM-1454 Reverse Curve Swithbacks
 Drawing Issued For: Reference

Page 2 of 3



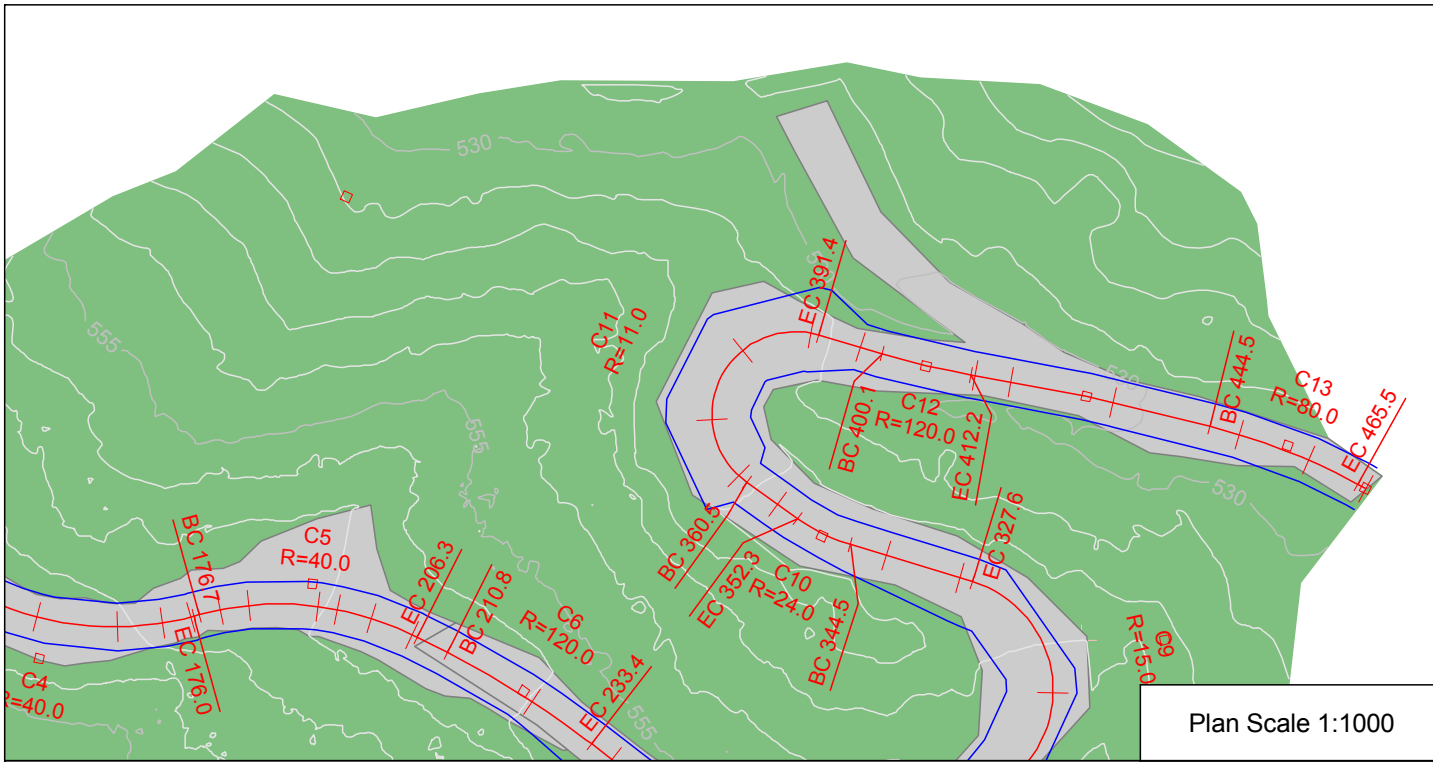

Plan Scale 1:1000
 Profile Vert Scale 1:1000
 Profile Horz Scale 1:1000

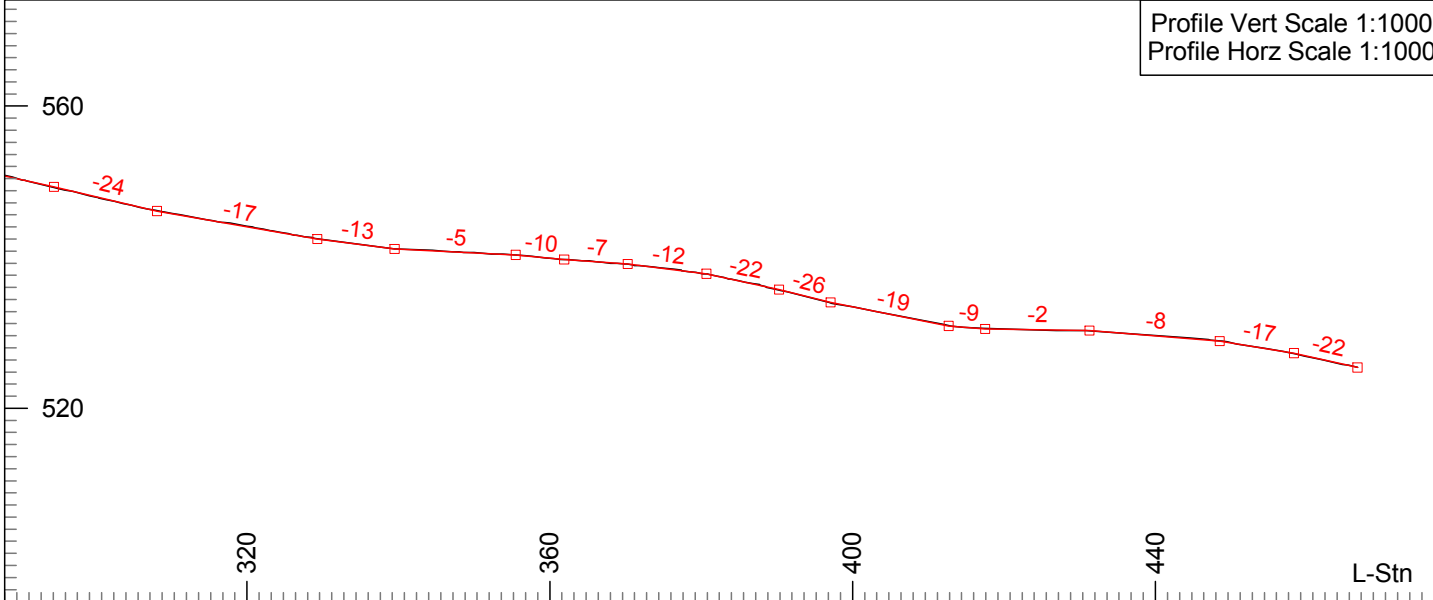

L-Stn m.	HD m.	SD m.	Grade %	H.Rad m.
308.1	19.5	19.8	-17.4	-15.0
327.6	1.7	1.8	-17.4	
329.3	10.2	10.3	-12.5	
339.5	5.0	5.0	-5.2	
344.5	7.8	7.8	-5.2	24.0
352.3	3.2	3.2	-5.2	
355.5	5.0	5.0	-9.7	
360.5	1.4	1.4	-9.7	11.0
361.9	8.4	8.4	-7.1	11.0
370.3	10.4	10.5	-11.9	11.0
380.7	9.6	9.8	-21.7	11.0
390.3	1.1	1.1	-26.2	11.0
391.4	5.7	5.9	-26.2	
397.1	3.0	3.0	-19.4	
400.1	12.1	12.3	-19.4	-120.0
412.2	0.6	0.6	-19.4	
412.7	4.8	4.8	-9.2	
417.5	13.8	13.8	-1.7	
431.3	13.2	13.2	-7.7	
444.5	4.0	4.0	-7.7	80.0
448.5	9.8	9.9	-16.7	80.0
458.3	7.2	7.4	-22.2	80.0
* 465.5	1.2	1.2	-22.2	
* 466.7				

Created By: Alex Forrester, P.Eng, R.P.F
 Date: January 18, 2016

As-built Drawing:
 KM-1454 Reverse Curve Swithbacks
 Drawing Issued For: Reference

Page 3 of 3

