


Plan Scale 1:1000
 Profile Vert Scale 1:1000
 Profile Horz Scale 1:1500

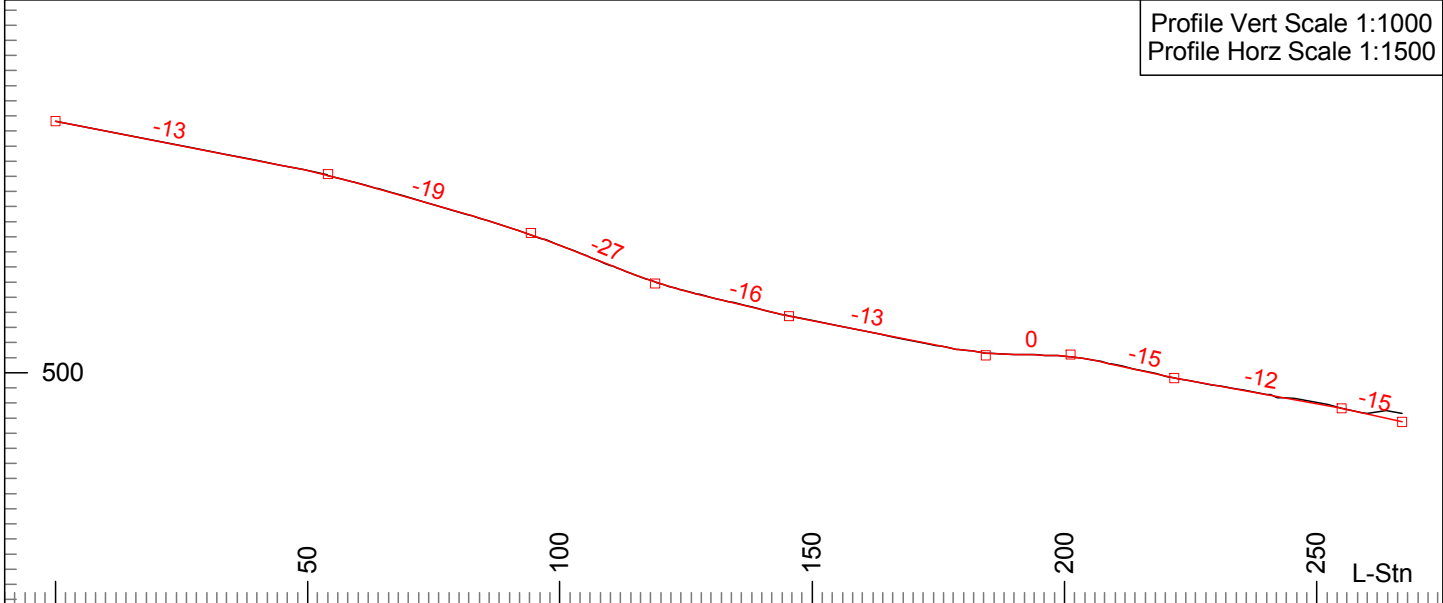

L-Stn m.	HD m.	SD m.	Grade %	H.Rad m.
44.4	9.5	9.6	p -14.5	
53.9	9.8	10.0	p -17.8	-80.0
63.7	18.8	19.1	-19.4	-80.0
82.5	3.3	3.4	p -20.0	-80.0
85.8	9.0	9.3	p -22.0	
94.9	11.1	11.5	p -25.4	17.0
106.0	4.5	4.7	-27.2	17.0
110.5	16.6	17.0	p -21.7	17.0
127.2	18.3	18.5	-16.2	17.0
145.5	0.2	0.2	-13.2	17.0
145.7	24.5	24.7	-13.2	
170.2	5.5	5.5	-13.2	60.0
175.7	17.6	17.6	p -6.5	60.0
193.2	0.4	0.4	0.3	60.0
193.6	7.7	7.7	p -3.5	60.0
201.3	5.9	5.9	p -10.3	
207.1	1.7	1.8	p -14.1	-60.0
208.9	12.8	13.0	-15.0	-60.0
221.7	16.1	16.2	-12.1	-60.0
237.8	17.2	17.3	-12.1	
254.9	12.0	12.1	-15.2	
266.9				

Created By: Alex Forrester, P.Eng, R.P.F
 Date: January 18, 2016

As-built Drawing:
 TK-0152 Steep Switchback
 Drawing Issued For: Reference

Page 1 of 1

