


Plan Scale 1:1000
 Profile Vert Scale 1:1000
 Profile Horz Scale 1:1500

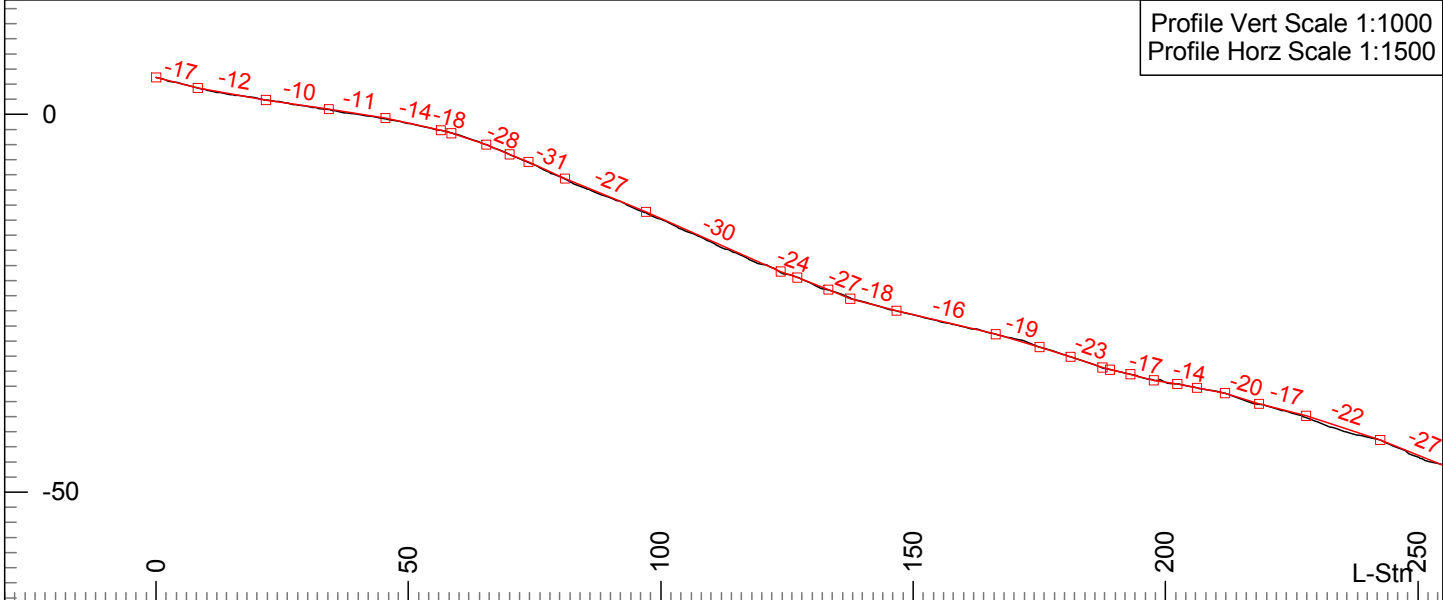


L-Stn m.	HD m.	SD m.	Grade %	H.Rad m.
8.2	13.5	13.6	-11.7	
21.8	12.5	12.5	-10.0	
34.2	11.2	11.2	-10.6	
45.4	10.9	11.1	-14.2	
56.3	2.2	2.2	-17.8	
58.5	6.9	7.1	-21.9	
65.4	2.2	2.3	-27.9	
67.6	2.5	2.6	-27.9	-24.0
70.1	3.6	3.8	-27.6	-24.0
73.7	7.2	7.6	-31.1	-24.0
81.0	16.1	16.7	-26.9	-24.0
97.1	26.7	27.8	-29.7	-24.0
123.8	3.3	3.4	-23.5	-24.0
127.1	3.5	3.6	-26.7	-24.0
130.6	2.6	2.7	-26.7	
133.2	4.3	4.5	-26.8	
137.5	9.2	9.3	-17.7	
146.7	0.6	0.6	-15.9	
147.3	19.1	19.3	-15.9	-80.0
166.3	5.2	5.3	-19.4	-80.0
171.6	3.5	3.6	-19.4	
175.1	6.0	6.2	-21.0	
181.2	6.4	6.6	-22.7	
187.6	1.4	1.5	-18.9	
189.0	4.0	4.1	-15.0	
193.0	1.6	1.6	-17.1	
194.6	3.0	3.1	-17.1	50.0
197.7	4.7	4.7	-9.8	50.0
202.4	3.8	3.9	-14.1	50.0
206.2	5.4	5.4	-12.3	50.0
211.6				

Created By: Alex Forrester, P.Eng, R.P.F
 Date: January 18, 2016


As-built Drawing:
 WP-2030 Steep Switchback
 Drawing Issued For: Reference

Page 1 of 2



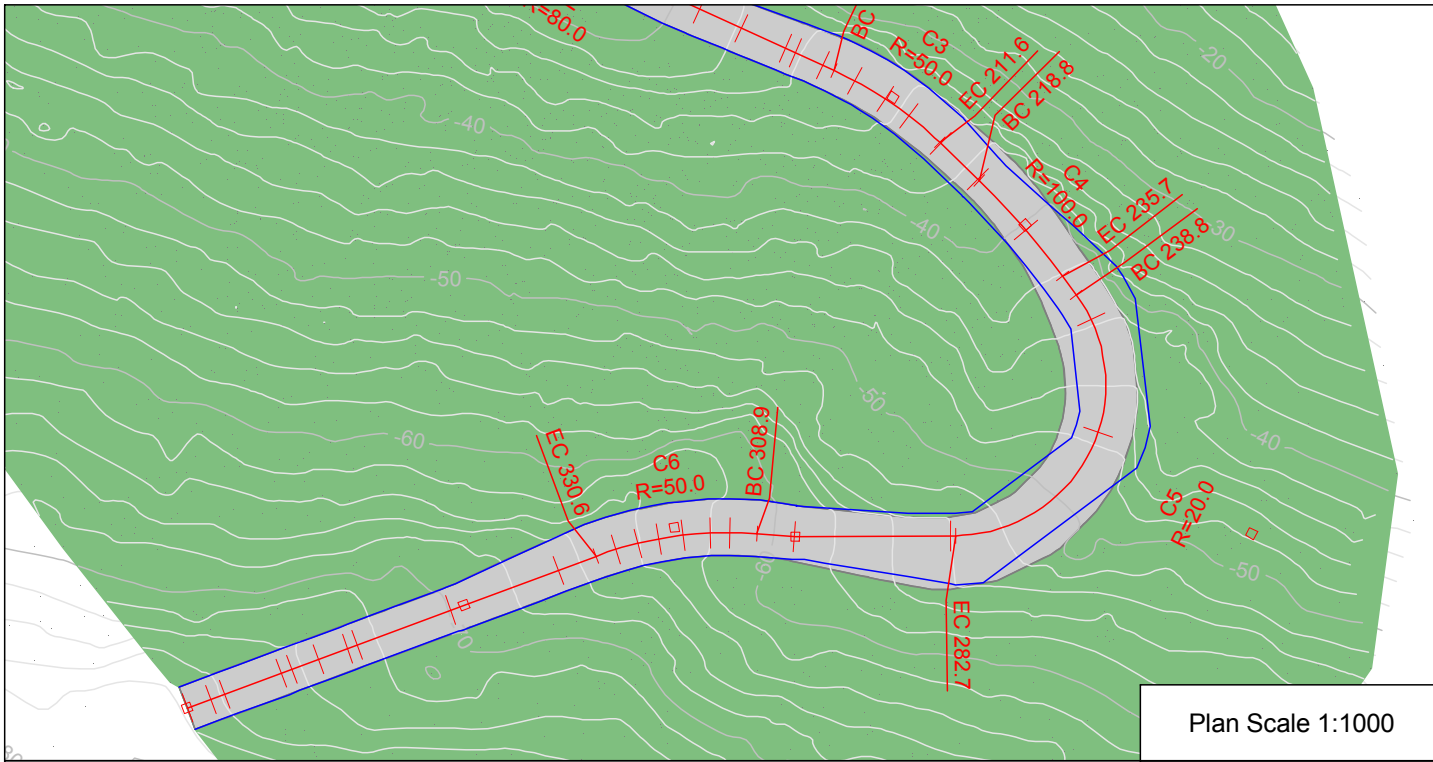

Plan Scale 1:1000
 Profile Vert Scale 1:1000
 Profile Horz Scale 1:1500

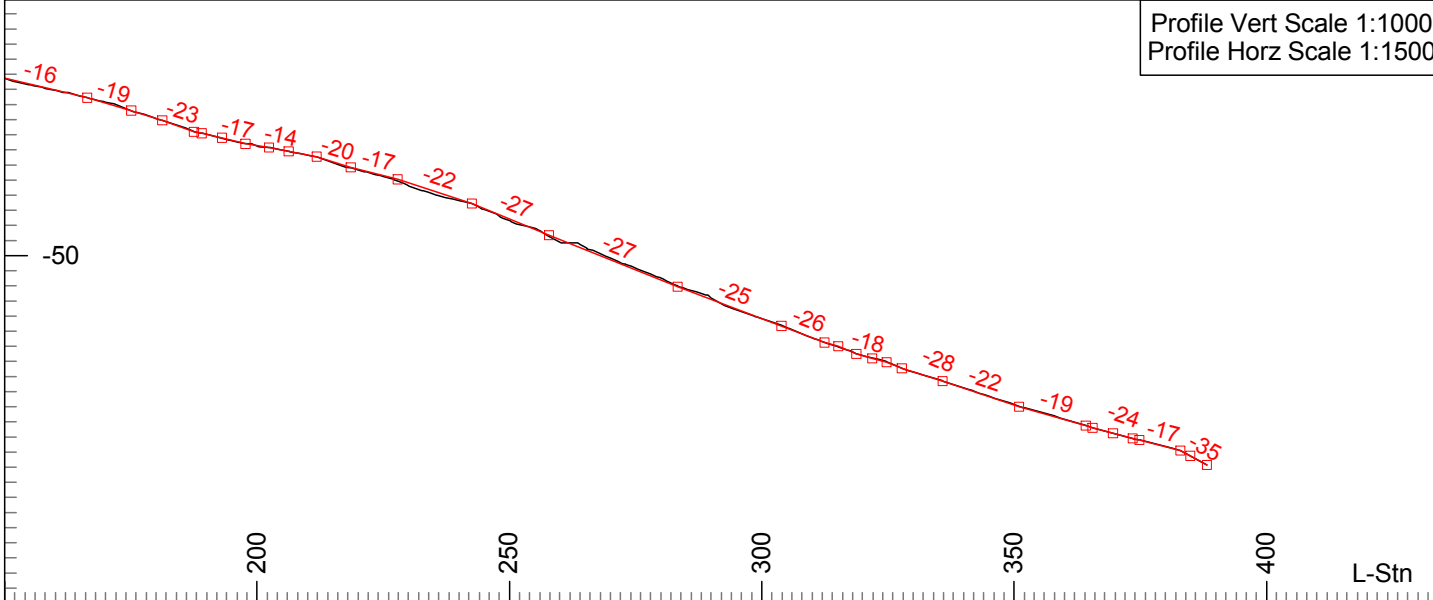

L-Stn m.	HD m.	SD m.	Grade %	H.Rad m.
193.0			-17.1	
194.6	1.6	1.6	-17.1	
197.7	3.0	3.1	-17.1	50.0
202.4	4.7	4.7	-9.8	50.0
206.2	3.8	3.9	-14.1	50.0
211.6	5.4	5.4	-12.3	50.0
211.8	0.2	0.2	-12.3	
218.6	6.8	7.0	-20.4	
218.8	0.3	0.3	-17.1	
227.9	9.0	9.1	-17.1	100.0
235.7	7.8	8.0	-22.1	100.0
238.8	3.1	3.2	-22.1	
242.5	3.8	3.9	-22.1	20.0
257.8	15.3	15.9	-27.0	20.0
282.7	24.8	25.7	-26.7	20.0
283.4	0.7	0.7	-26.7	
304.0	20.6	21.2	-25.2	
308.9	5.0	5.1	-26.2	
312.5	3.6	3.7	-26.2	-50.0
315.1	2.6	2.7	-19.6	-50.0
318.7	3.6	3.7	-26.6	-50.0
322.0	3.2	3.3	-18.4	-50.0
324.8	2.8	2.9	-18.2	-50.0
327.8	3.0	3.1	-27.8	-50.0
330.6	2.8	2.8	-20.4	-50.0
335.9	5.3	5.4	-20.4	
351.1	15.2	15.6	-22.3	
364.2	13.2	13.4	-19.0	
365.6	1.3	1.4	-24.2	
369.6	4.1	4.1	-17.4	
373.5	3.8	3.9	-19.1	
374.9	1.5	1.5	-15.0	
382.9	8.0	8.1	-16.7	
384.9	2.0	2.1	-36.7	
388.2	3.3	3.5	-35.3	

Created By: Alex Forrester, P.Eng, R.P.F
 Date: January 18, 2016

As-built Drawing:
 WP-2030 Steep Switchback
 Drawing Issued For: Reference

Page 2 of 2

